



C. Earl Hunter, Commissioner

Promoting and protecting the health of the public and the environment.

PUBLIC NOTICE AMENDMENT REQUEST

The permittee for P/N# **OCRM-05-243-R, Vincent Brown**, has requested an amendment to that issued permit. Specifically, the applicant proposes to re-deck the existing 4' x 50' walkway, 10' x 10' pierhead, and 8' x 20' floating dock. The proposed amendment is for modifications to a private recreational dock on and adjacent to Atlantic Intracoastal Waterway at 3 Conquest Ave, Sullivans Island, Charleston County, South Carolina.

Written comments will be received on this amendment request until October 8, 2007 at the address listed below. For further information please contact the project manager, Josh Young, 843-953-0257.

 September 28, 2007

SOUTH CAROLINA DEPARTMENT OF HEALTH AND ENVIRONMENTAL CONTROL

Ocean and Coastal Resource Management

Charleston Office • 1362 McMillan Avenue, Suite 400 • Charleston, SC 29405

Phone: 843-953-0200 • Fax: 843-953-0201 • www.scdhec.gov


MONUMENTS USED:

USCOE MONUMENT
1276+32.45S 160' LT
N = 341705.320
E = 2348776.050

USCOE MONUMENT
1270+88.94S 160' LT
N = 341374.830
E = 2349207.500

N = 341370.242
E = 2349287.151

N = 341335.639
E = 2349334.112

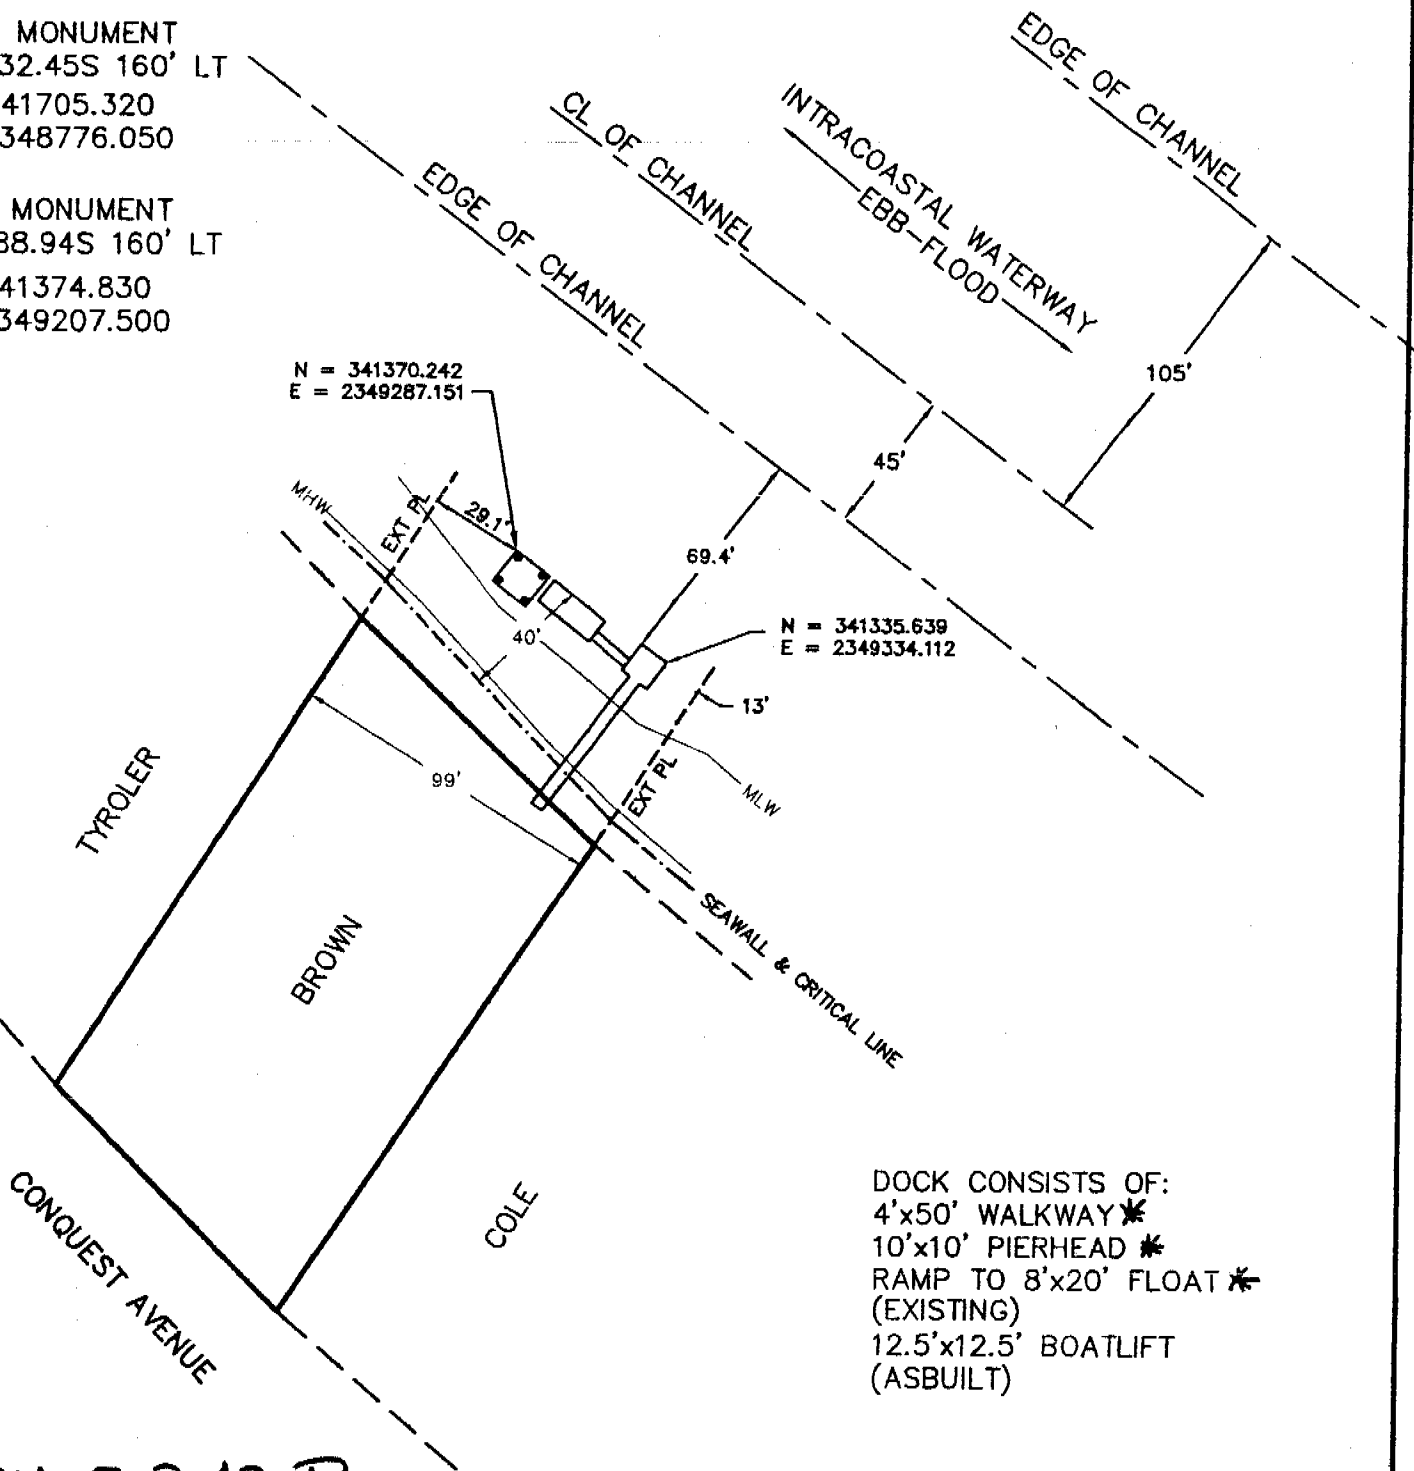

DOCK CONSISTS OF:
4'x50' WALKWAY *
10'x10' PIERHEAD *
RAMP TO 8'x20' FLOAT *
(EXISTING)
12.5'x12.5' BOATLIFT
(ASBUILT)

OCRM-05-243-R

Amendment to Redeck existing dock *

APPLICANT: VINCENT BROWN
#3 CONQUEST AVENUE
SULLIVANS ISLAND
CHARLESTON COUNTY
TMS#523-06-00-029
INTRACOASTAL WATERWAY


BOATLIFT ASBUILT
PRIVATE
RECREATIONAL
DOCK

DATE: AUGUST 30, 2007

SCALE: 1" = 60'



60 0 60

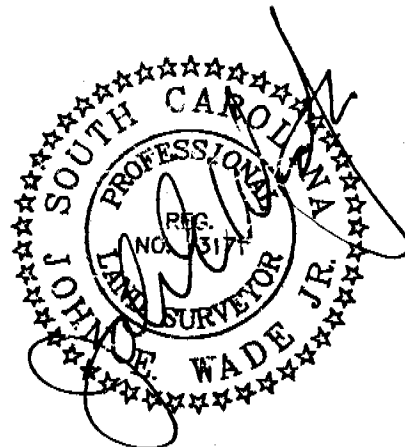

FILE #184-05